



Jerusalem Schoolhouse
 Village of Jerusalem, Vermont
 MAIN LEVEL FLOOR PLAN
 EXISTING
 SCALE 1/8" = 1' - 0"

Measuring DATE: February 4, 2012

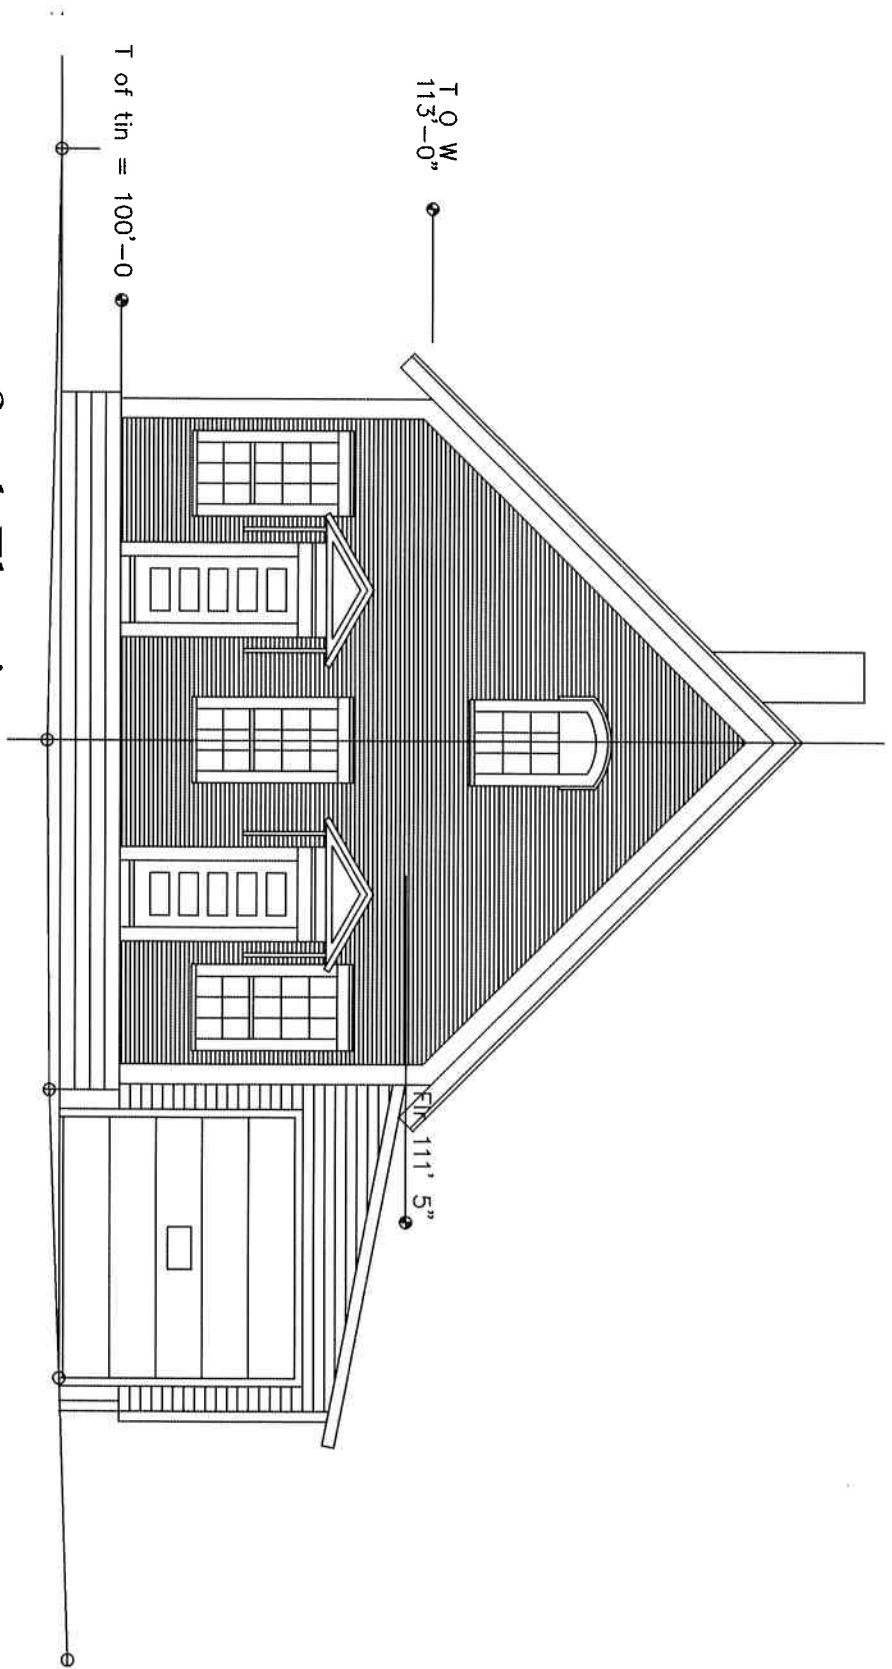


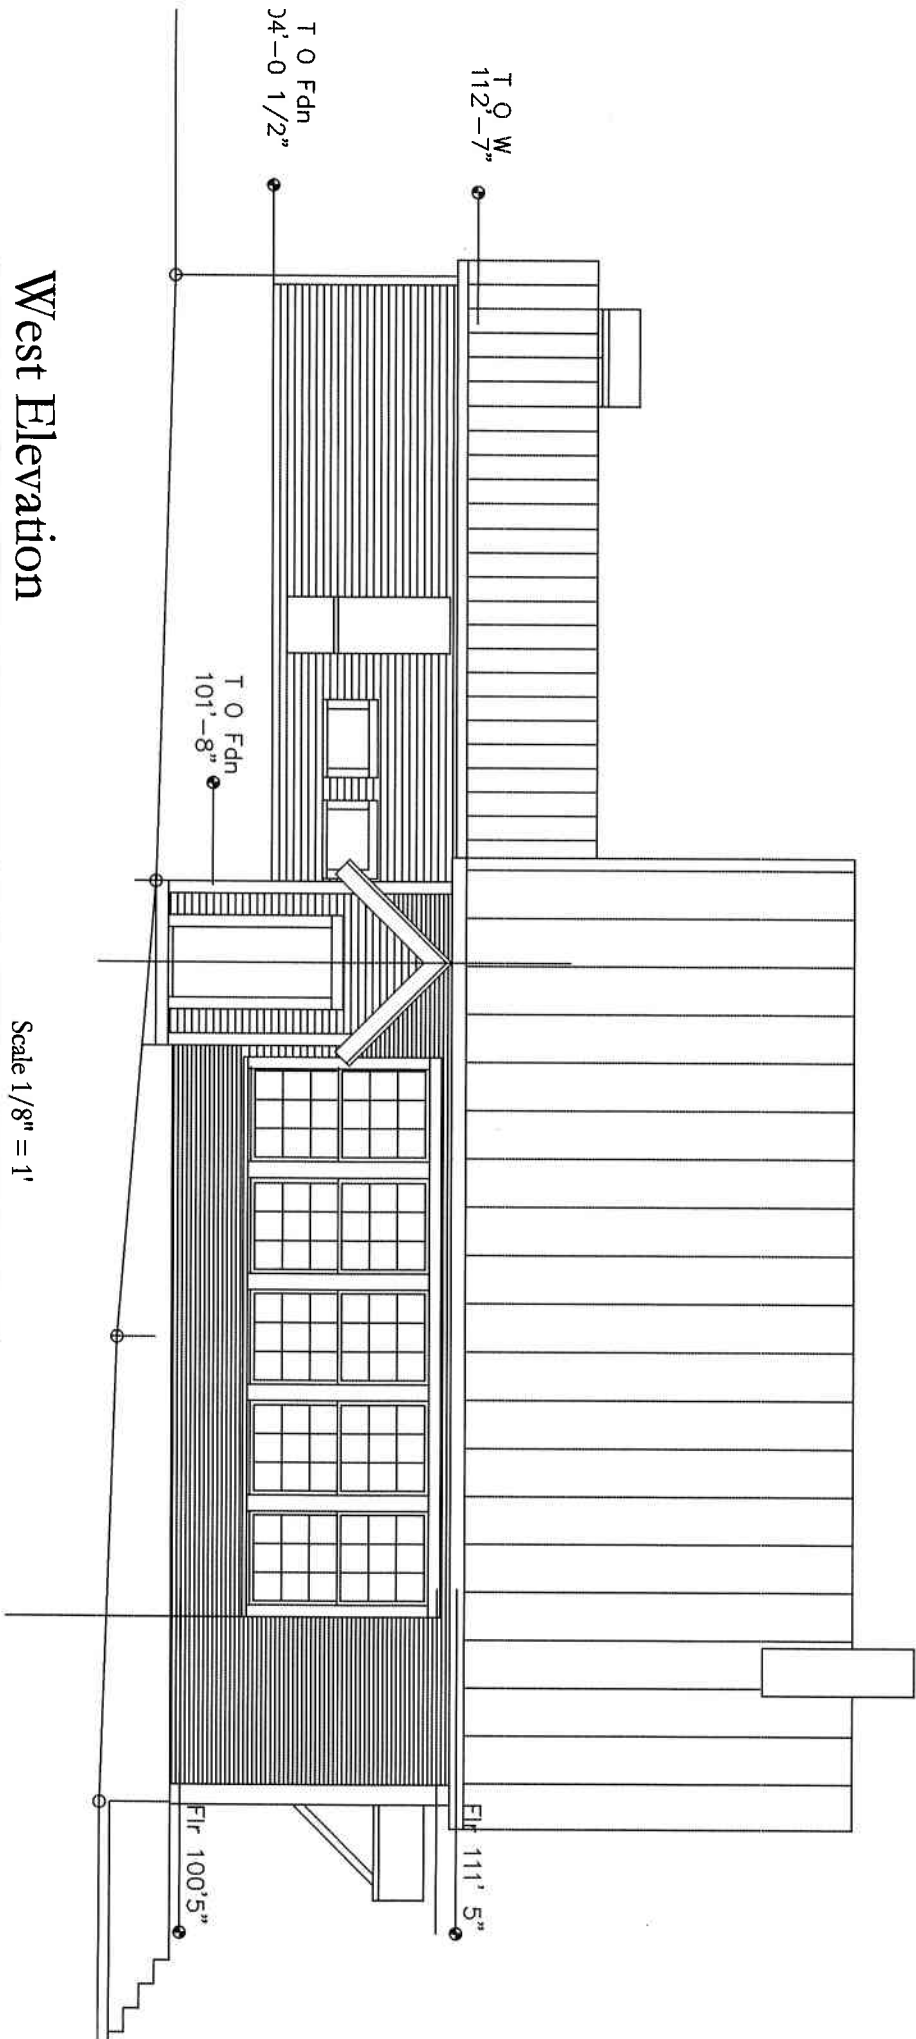

West Elevation

EXISTING

Scale 1/8" = 1'

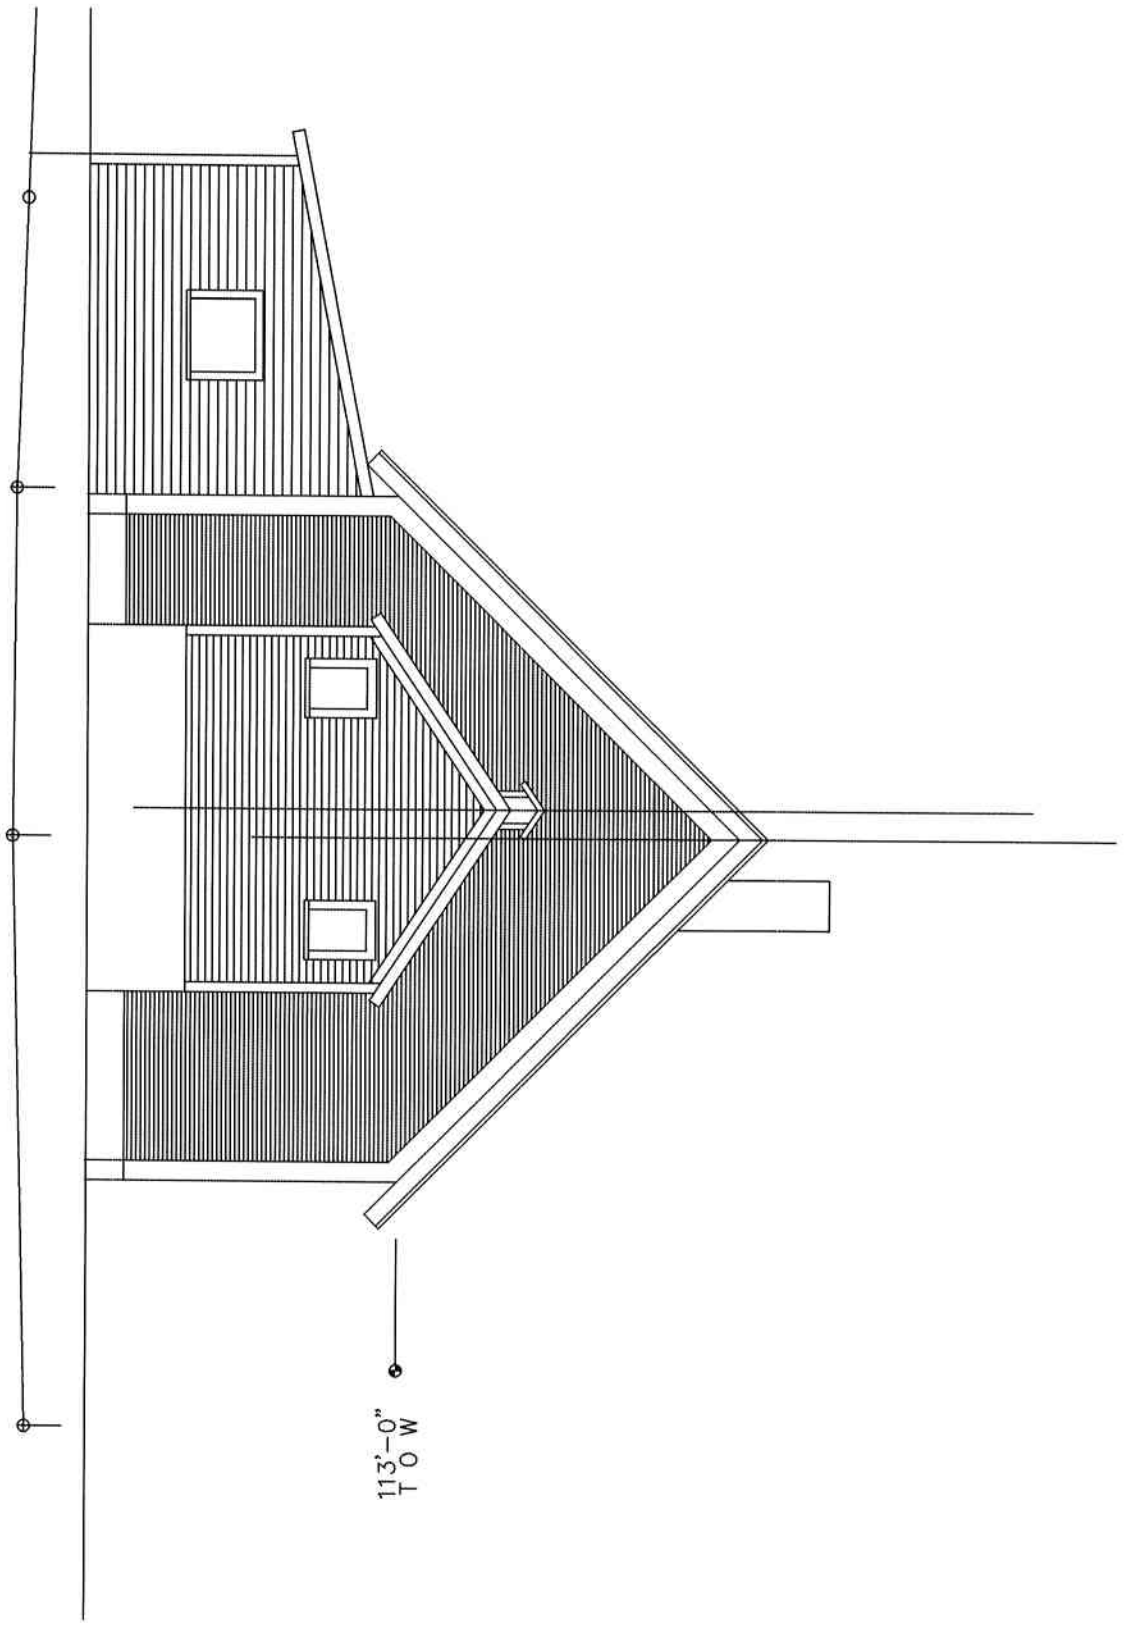


North Elevation

EXISTING

Scale 1/8" = 1'

113'-0"
TO W

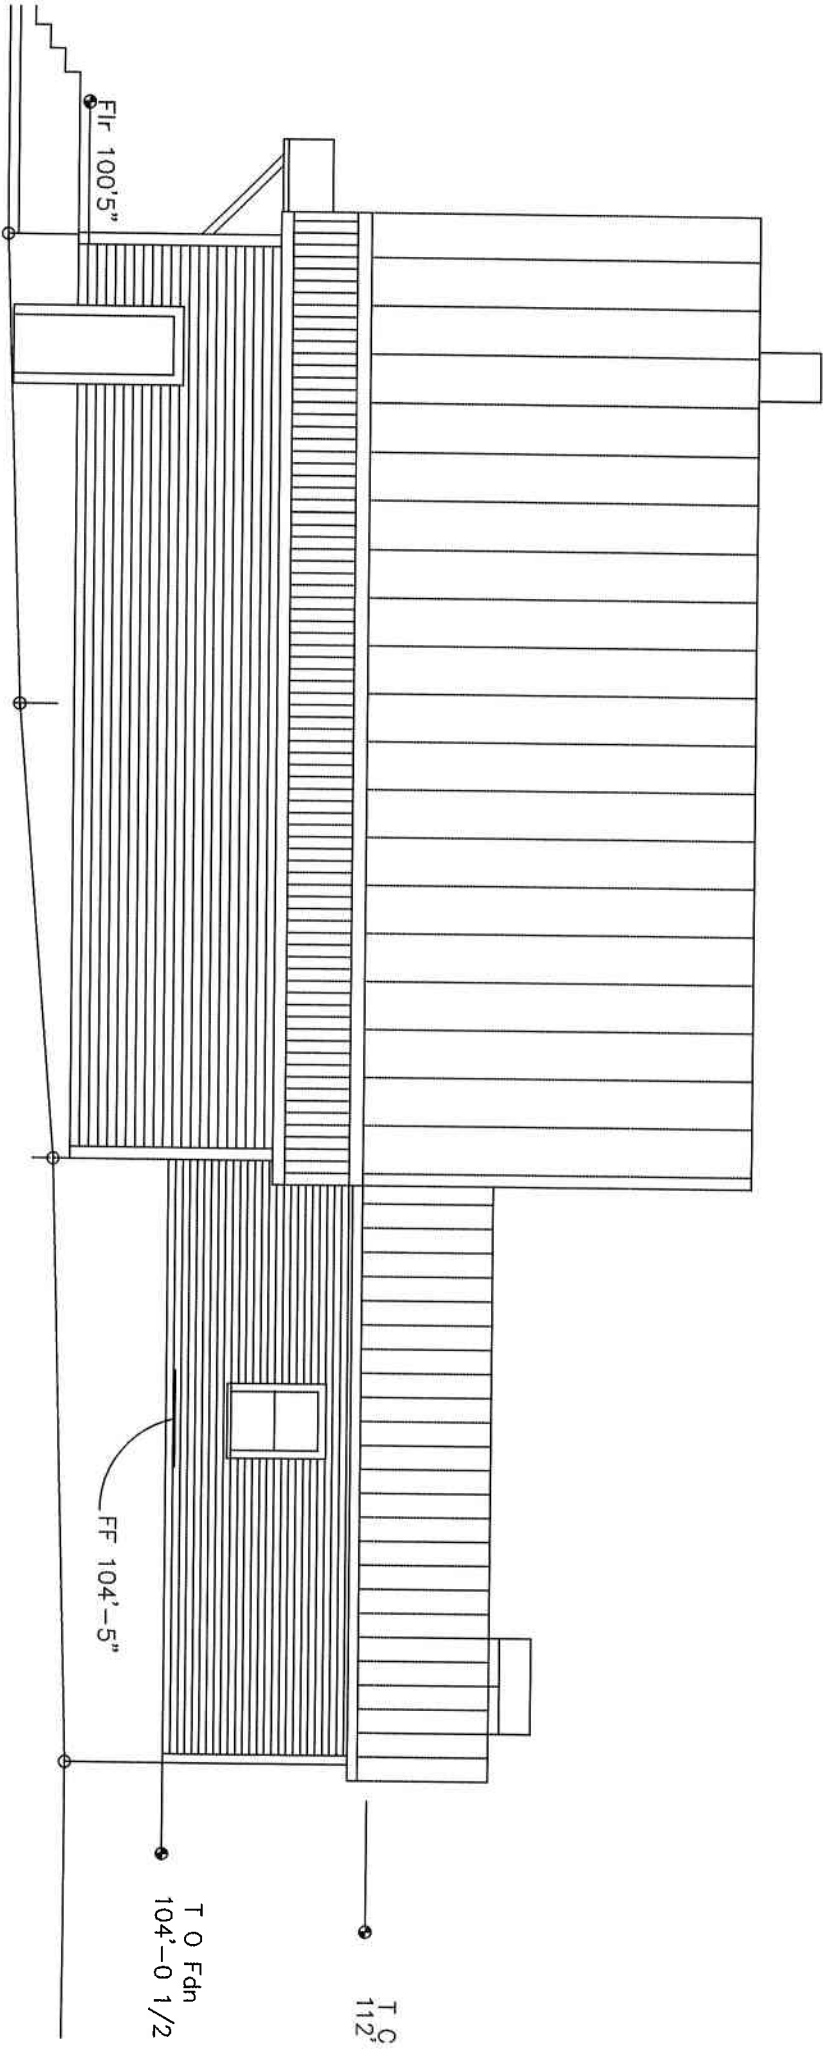

Scale 1/8" = 1'

East Elevation

EXISTING